Amended plan rec'd 11.2.92

SUPERSEDED B/90/1219

Existing Site Plan

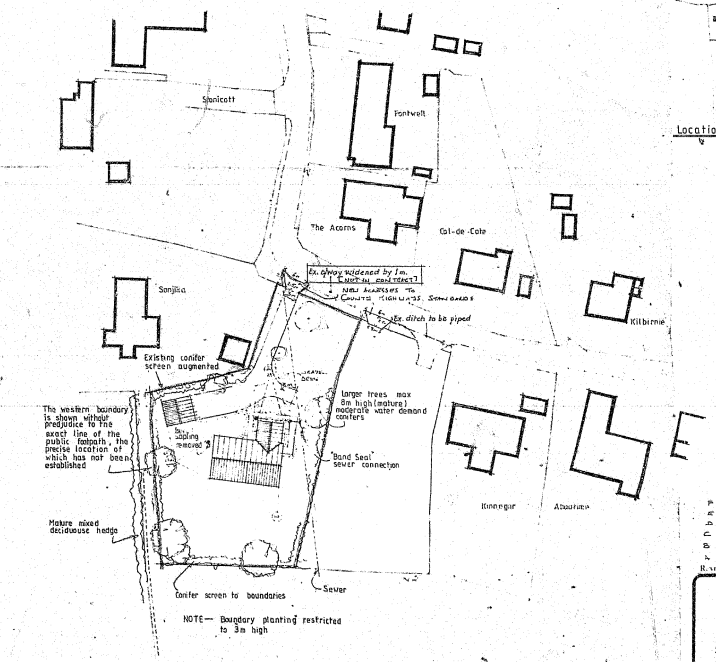

NOTE— Boundary planting restricted to 3m high

Proposed Site Plan

Site area 0·33 ha

NOTE—
All hedge & tree planting to be agreed with local Planning Authority

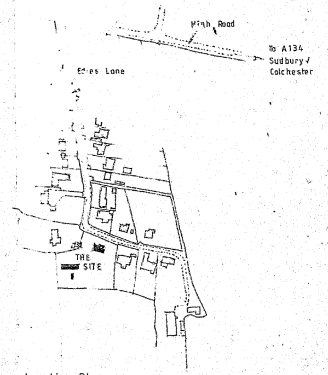

Location Plan

DC 102 access, 150 concrete with 2 layers B503 reinforcement mesh over 150 well consolidated hardcore

Front & rear edges protected by BS 340 Bullnose dropped road kerbs bedded on 8 haunched with 100 concrete.

Ditched piped with 150ø ø pvc flexible jointed land drainage pipe encased in 100 granular surround.

Back filled with approved excavation material & consolidated in layers not exceeding 225mm

11 FEB 1992

For illustration purposes only

Rev	Date	Amendment
F	27.10.91	Houses & Drive Notes Added
E	2.10.91	Western Boundary Amended
D	11.9.91	Additional Planting Indication Added
C	11.1.90	Drives Added
B	9.9.90	Garage Porch Amended
A	31.7.90	Site Plan Amended

William H. Brown
PROFESSIONAL
Building Surveyors & Planning Consultants
23/24 MARKET HILL, SUDBURY, SUFFOLK CO10 6EN
TEL (0787) 72247

Title: Land at Orchard Lea, Edies Lane, Leavenheath, Suffolk.

Site and Location Plans (West Plot)

Scale: 1:500, 1:2500		Date: Oct 1989	
Job no: 1147	Dwg. no: A/5	Drawn by:	

G 10.12.91 Drive Kerbs Amended